
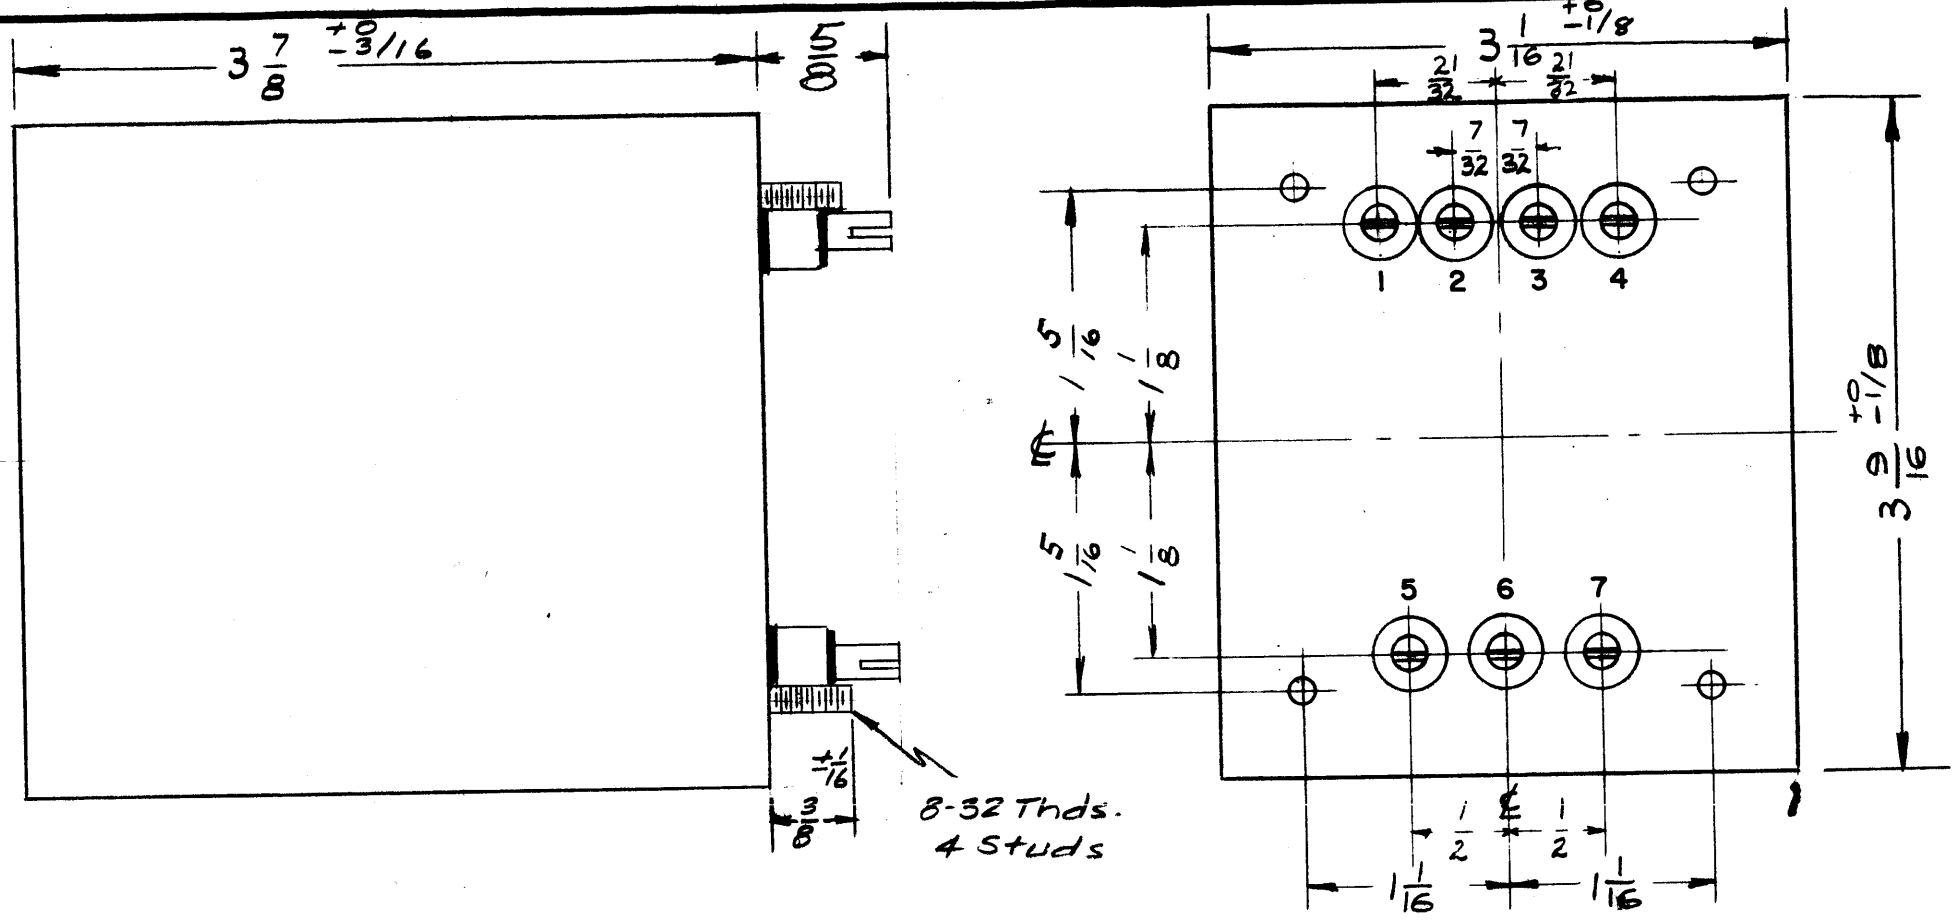


TF-202 C

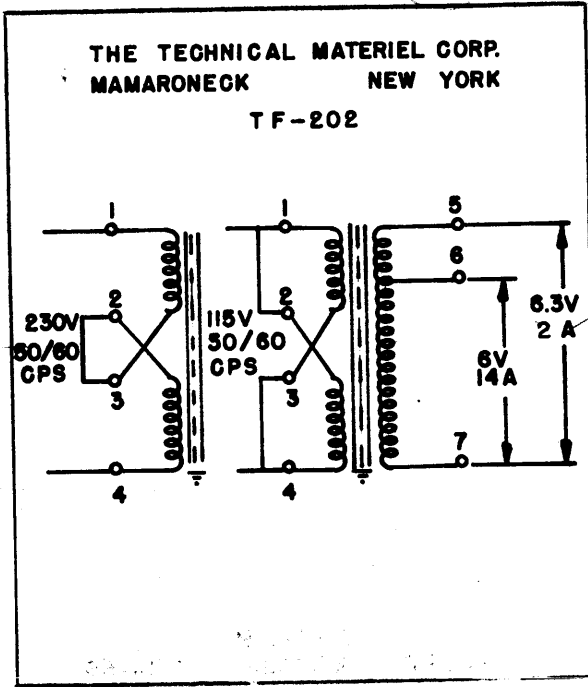

**ELECTRICAL SPECIFICATIONS:**

PRIMARY: 115/230 VAC, 50/60 CPS, SINGLE PHASE  
 SECONDARY: 6.3V/.2 AMPS AND 6 V/14 AMPS.

**MECHANICAL SPECIFICATIONS:**

CASE: RECTANGULAR STEEL, MIL TYPE JB, HERMETICALLY SEALED.  
 FINISH: TMC SMOOTH GREY ENAMEL (S-115), EXCEPT TERMINAL END.  
 STAMPING: TERMINALS SHALL BE METAL STAMPED 1 TO 7 AS SHOWN. OPPOSITE END SHALL BE RUBBER STAMPED AS SHOWN.

NOTE: MANUFACTURED IN ACCORDANCE WITH MIL SPEC T-27-A EXCEPT THAT MIL SPEC T-27-A SHALL NOT APPEAR ON CASE AND QUALIFICATION TESTING IS NOT REQUIRED.

~~TRANSFORMER SHALL BE IN ACCORDANCE WITH~~  
~~MIL T-27A AND AMENDMENT~~  
~~GRADE 1 CLASS A PAPER 01~~  
~~MIL SPEC T-27-A~~

ISSUE	ITEM	CHANGED FROM	DATE	CH. NO.	DRAFTS	CHECKER	ENG. APP.
C	1	5/8 DIM. WAS 1/16	9/27/63	10102	208	ARB	
B	1	NOTE ADDED (MIL T-27A)	6-30-60	2572	14	ARB	
A	*	21/32 WAS 5/8	11/12/68		14	ARB	

TOLERANCES: DEC. DIM. ±, FRAC. DIM. ±, ANGULAR DIM. ±

SCALE: 1-1101

MAXIMUM ALLOWABLE TOLERANCES HAVE BEEN DETERMINED AND ANY DEVIATIONS WILL BE CAUSE FOR REJECTION. REMOVE ALL BURRS AND SHARP EDGES

REQ. PER UNIT	GPT-10K	AX-104	1178-58
	MODEL	PROJECT NO.	ASS'Y. NO.
	USED ON		

REQ. ITEM	PART NO.	DESCRIPTION	SYMBOL
		THE TECHNICAL MATERIEL CORP. MAMARONECK, NEW YORK	
		TRANSFORMER, POWER, STEP DOWN, FILAMENT (6.3V)	
		TORILLO 16	ARB
		TYPE & TEMPER	HEAT TREAT. SPEC.
		DRAWN	CHECKED
		FINISH & SPEC. NO.	ELEC. DES. APP. MECH. DES. APP.
		TF.G. 203	TF-202 - C